

Dane County Zoning Permit Application

PERMIT NO. **N^o 37290**

LOCATION:		2058 BARBER DRIVE		DUNN		26 NW	
NUMBER	ROAD	TOWN	SECTION		1/4		1/4
6	LINCOLN PARK	14-53-1402	C.U.P. NO.		R-3		
LOT	BLOCK	SUBDIVISION NAME OR C. S. M. NUMBER	PARCEL NO.		C.U.P. NO.		ZONE
ROAD:		PROPOSED USE:					
CLASS D	<input type="checkbox"/> 101 ONE FAMILY BUILDING <input type="checkbox"/> 324 OFFICE/BANK/PROFESSIONAL						
WIDTH 66	<input type="checkbox"/> 102 TWO FAMILY BUILDING <input type="checkbox"/> 325 PUBLIC WORKS/UTILITIES						
TYPE OF IMPROVEMENT:		<input type="checkbox"/> 104 THREE/FOUR FAMILY BUILDING <input type="checkbox"/> 326 SCHOOLS/EDUCATIONAL					
<input checked="" type="checkbox"/> NEW BUILDING		<input type="checkbox"/> 105 FIVE/MORE FAMILY BUILDING <input type="checkbox"/> 327 STORES/MERCANTILE					
<input checked="" type="checkbox"/> ADDITION		<input type="checkbox"/> 213 HOTELS/MOTELS <input type="checkbox"/> 328 OTHER NON-RESIDENTIAL BUILDINGS					
<input type="checkbox"/> ALTERATION		<input type="checkbox"/> 318 AMUSEMENT/RECREATIONAL BLDG. <input type="checkbox"/> 329 STRUCTURES OTHER THAN BUILDINGS					
<input type="checkbox"/> REPAIR/REPLACEMENT		<input type="checkbox"/> 319 CHURCHES/RELIGIOUS BUILDING <input checked="" type="checkbox"/> 434 ADDN./ALT. HOUSEKEEPING BUILDINGS					
<input type="checkbox"/> MOVING/RELOCATION		<input type="checkbox"/> 320 INDUSTRIAL BUILDINGS <input type="checkbox"/> 436 RESIDENTIAL GARAGES/CARPORTS					
TYPE OF FRAME:		PROPOSED USE: (If non-residential, describe in detail).					
<input checked="" type="checkbox"/> WOOD FRAME		WOOD DECK					
<input type="checkbox"/> MASONRY (WALL BEARING)		OWNER:					
<input type="checkbox"/> STRUCTURAL STEEL		DONALD GRUBB					
<input type="checkbox"/> REINFORCED CONCRETE		509 SHEARWATER ST.					
<input type="checkbox"/> OTHER		MADISON 53714					
SEWAGE DISPOSAL:		CONTRACTOR:					
<input type="checkbox"/> PUBLIC		FRAN STEELE					
<input checked="" type="checkbox"/> PRIVATE		MCFARLAND					
PERMIT NO. 85-0031	The undersigned and the owner of this building agree to conform to all applicable ordinances of Dane County.						
DIMENSIONS:	<input checked="" type="checkbox"/> DONALD M. GRUBB						
LONG 26 WIDE 6	Signature of owner or his agent. _____ Date _____						
STORIES 1 FEET	INSPECTION RECORD:						
TOTAL FLOOR AREA _____	FRONT YARD <input checked="" type="checkbox"/> RIGHT YARD <input checked="" type="checkbox"/> LEFT YARD <input checked="" type="checkbox"/> REAR YARD <input checked="" type="checkbox"/>						
TOTAL LOT AREA _____	DATE _____ BY _____ CERTIFICATE ISSUED _____ BY _____						
PARKING SPACES:	NOTATION:						
REQUIRED _____	10' min SIDEYARDS 34' min TO						
FURNISHED _____	NHWH						
SHORELAND/FLOOD PLAIN:	SEE PMT 36868						
PERMIT NO. _____	AREA:						
VARIANCE:	BASEMENT _____ FIRST _____ SECOND _____ TOTAL _____						
PERMIT NO. 1414	COST: 1600 FEE: 2500						
DWELLING UNITS (003-004)	ISSUED BY: <i>[Signature]</i> DATE: 7-29-85						
1 BEDROOM _____	PDA						
2 BEDROOM _____							
3 BEDROOM _____							
TOTAL _____							

37290




Lot 6, Lincoln Park, being part of the NW 1/4 of Section 26, T6N, R10E,
Town of Dunn, Dane County, Wisconsin.


MAP NO. 84003

CLAYTON SURVEYING AND TESTING Co.
4891 East Clayton Rd., Madison, Wisconsin, 53711

(608) 271-8194

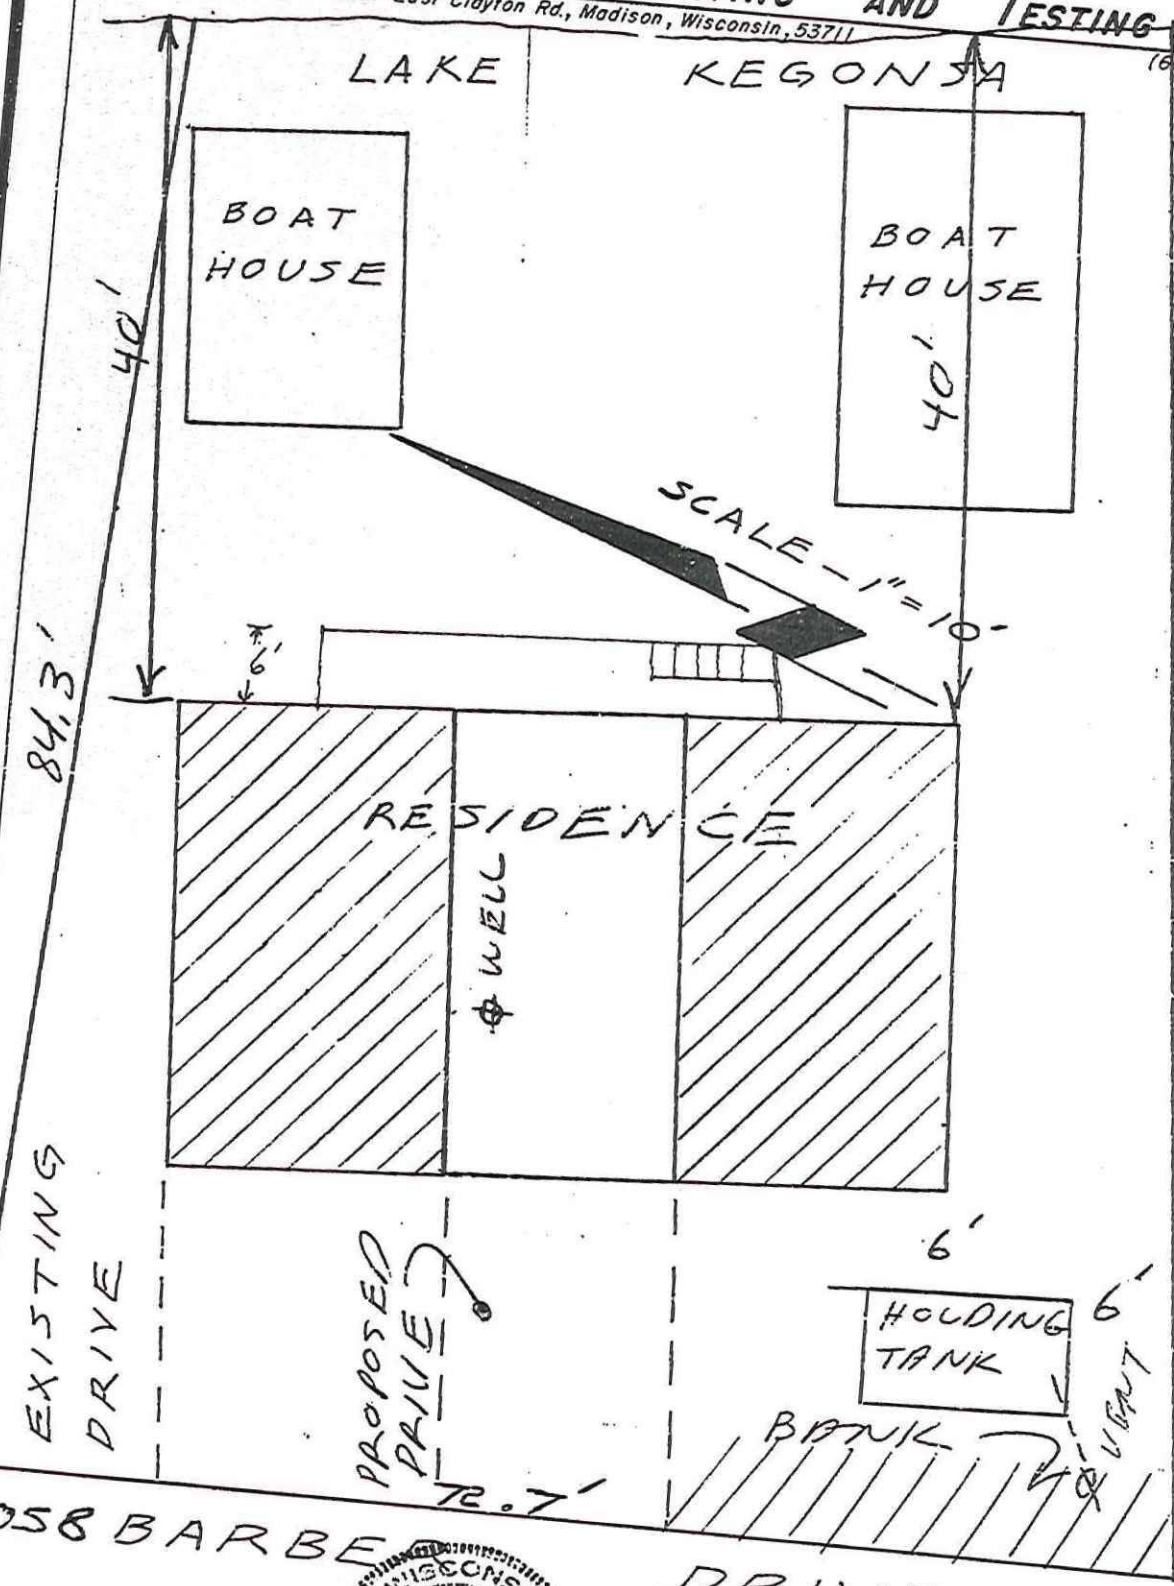

DATE: 1/27/84
CST NO. 84003
SHEET 1 OF 1

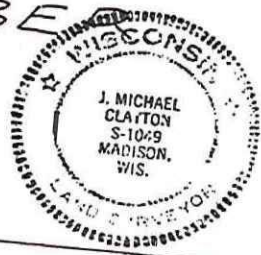

DRIVE
Dennis Ampe

#1414. DUNDAS ST
Lot #6, Lincoln Park - Section 26
Town of Dunn


37290

Min. Setback (Ave.) from normal high
waterline: 34 feet

Req's. Variance: 7± feet.

RE: Entry addition as constructed.


LAKE KEGONSA

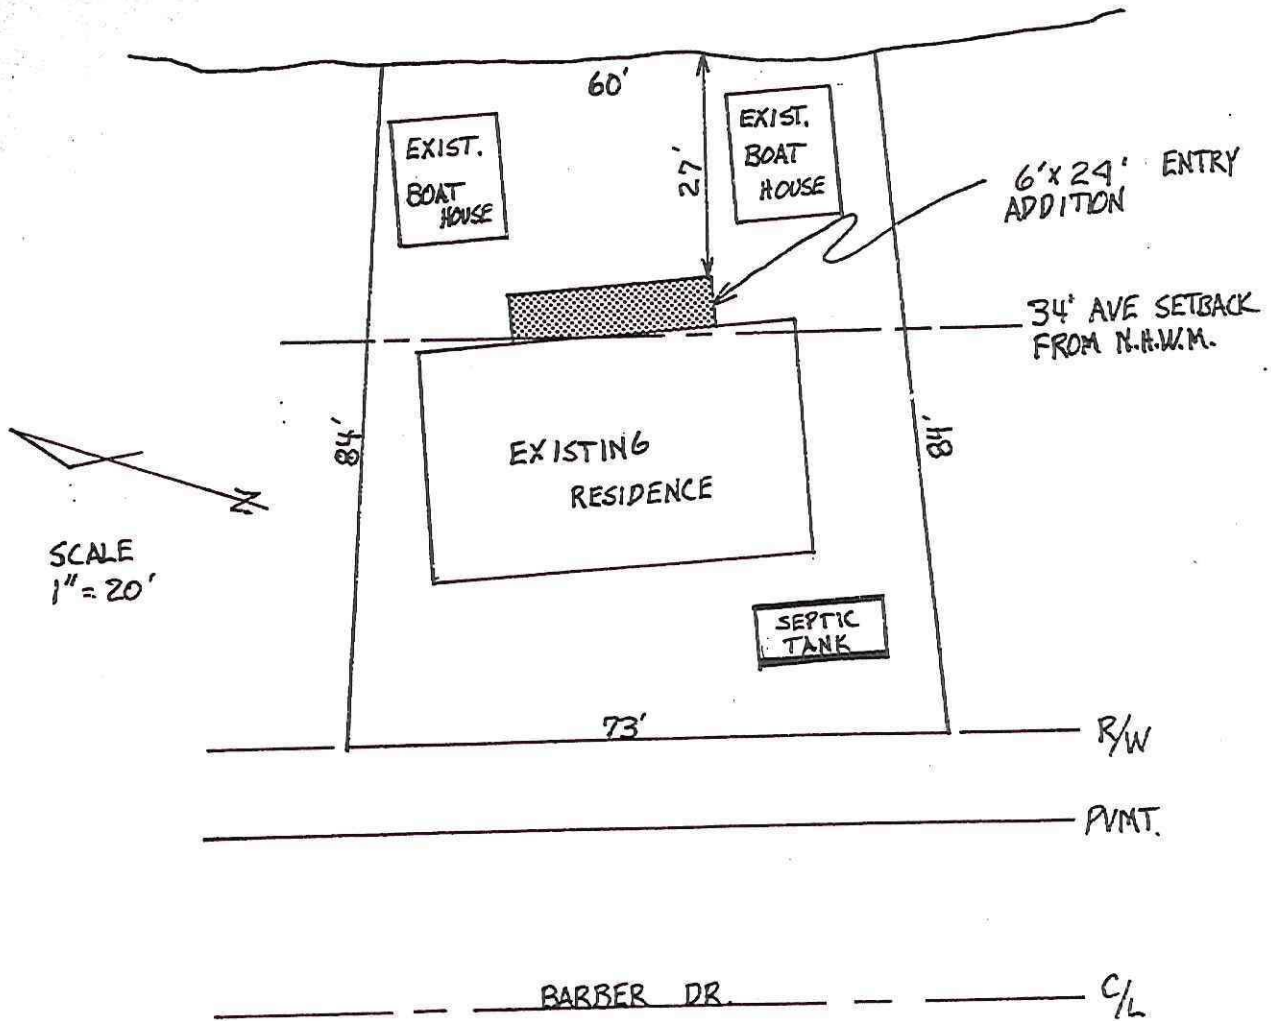

SCALE
1" = 20'

#1414. Grubb

37290

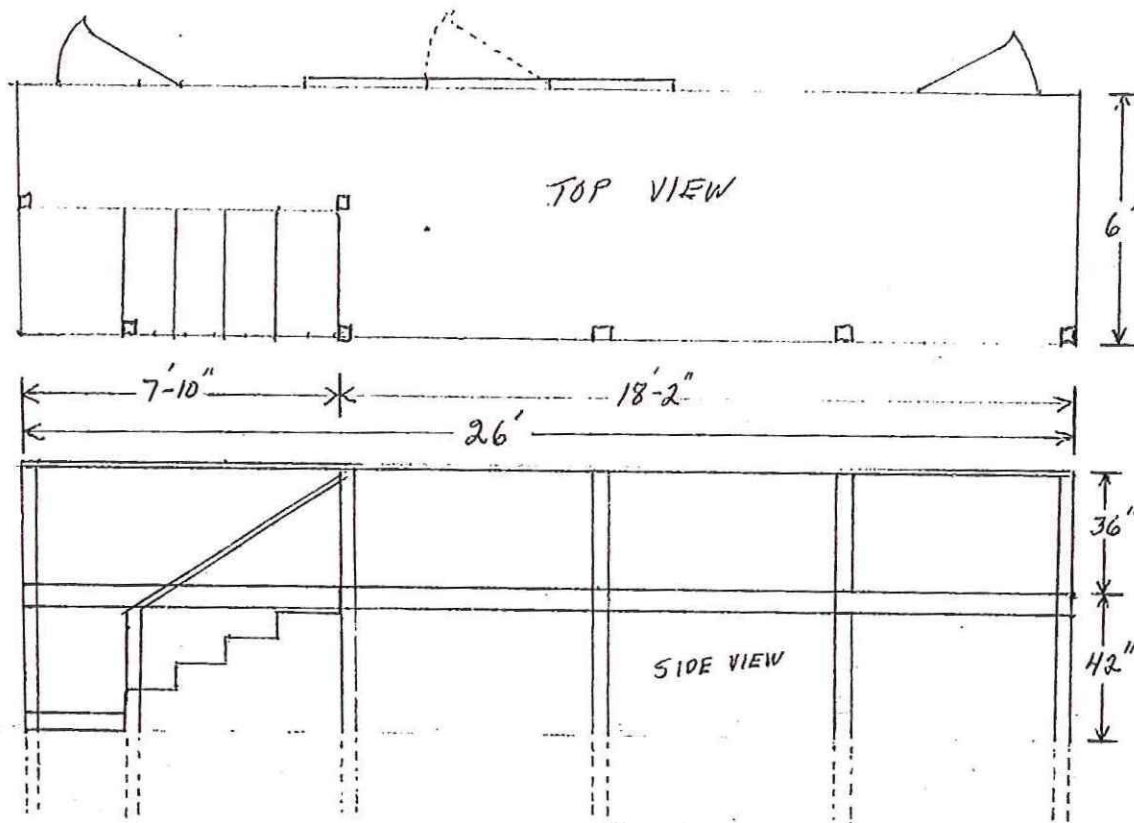

Don Grubb -
2060 Barber Dr.
Stoughton, W. Va. 53588

LOT - 6, Lincoln Park
Panel # 1453-1402