State of Wisconsin
DEPARTMENT OF NATURAL RESOURCES
2300 N. Dr. Martin Luther King, Jr. Drive
Milwaukee, WI 53212-3128

Tony Evers, Governor Preston D. Cole, Secretary Telephone 608-266-2621 Toll Free 1-888-936-7463 TTY Access via relay - 711



November 26, 2019

WIC-SC-2019-13-03831

Unbridled Spirits LLC Stacy Bean 2782 White Crossing Road Verona, WI 53593

RE: Wetland Delineation Report for "Unbridled Spirits LLC Proposed Road Improvements" located in the SW1/4 of the SE1/4 of Section 07, Township 06 North, Range 08 East, City of Verona, Dane County

Dear Ms. Bean:

We have received and reviewed the wetland delineation report prepared for the above-mentioned site by Tetra Tech Inc. This letter will serve as confirmation that the wetland boundaries as shown on the included wetland delineation map are acceptable. This finding is based upon a field visit. Any filling or grading within these areas will require DNR approvals. Our wetland confirmation is valid for five years unless altered site conditions warrant a new wetland delineation be conducted. Be sure to send a copy of the report, as well as any approved revisions, to the U.S. Army Corps of Engineers.

In order to comply with Chapter 23.321, State Statutes, please supply the department with a polygon shapefile of the wetland boundaries delineated within the project area. Please do not include data such as parcel boundaries, project limits, wetland graphic representation symbols, etc. If internal upland polygons are found within a wetland polygon, then please label as UPLAND. The shapefile should utilize a State Plane Projection, and be overlain onto recent aerial photography. If a different projection system is used, please indicate what system the data are projected to. In the correspondence sent with the shapefile, please supply a brief description of each wetland's plant community (eg: wet meadow, floodplain forest, etc.). Please send these data to Calvin Lawrence (608-266-0756, or calvin.lawrence@wisconsin.gov).

If you are planning development on the property, you are required to avoid take of endangered and threatened species, or obtain an incidental take authorization or permit, to comply with the state's Endangered Species Law. To insure compliance with the law, you should submit an endangered resources review form (Form 1700-047), available at http://dnr.wi.gov/topic/ERReview/Review.html. The Endangered Resources Program will provide a review response letter identifying any endangered and threatened species and any conditions that must be followed to address potential incidental take.

In addition to contacting WDNR, be sure to contact your local zoning office and U.S. Army Corps of Engineers to determine if any local or federal permits may be required for your project.



If you have any questions, please contact me at (414) 308-6780 or email kara.brooks@wisconsin.gov.


Sincerely,

Kara Brooks

Wetland Identification Specialist

Kerrie Hauser, Project Manager, U.S. Army Corps of Engineers Lucas Specketer, Tetra Tech Inc. CC:

Allen Ramminger, DNR Water Management Specialist

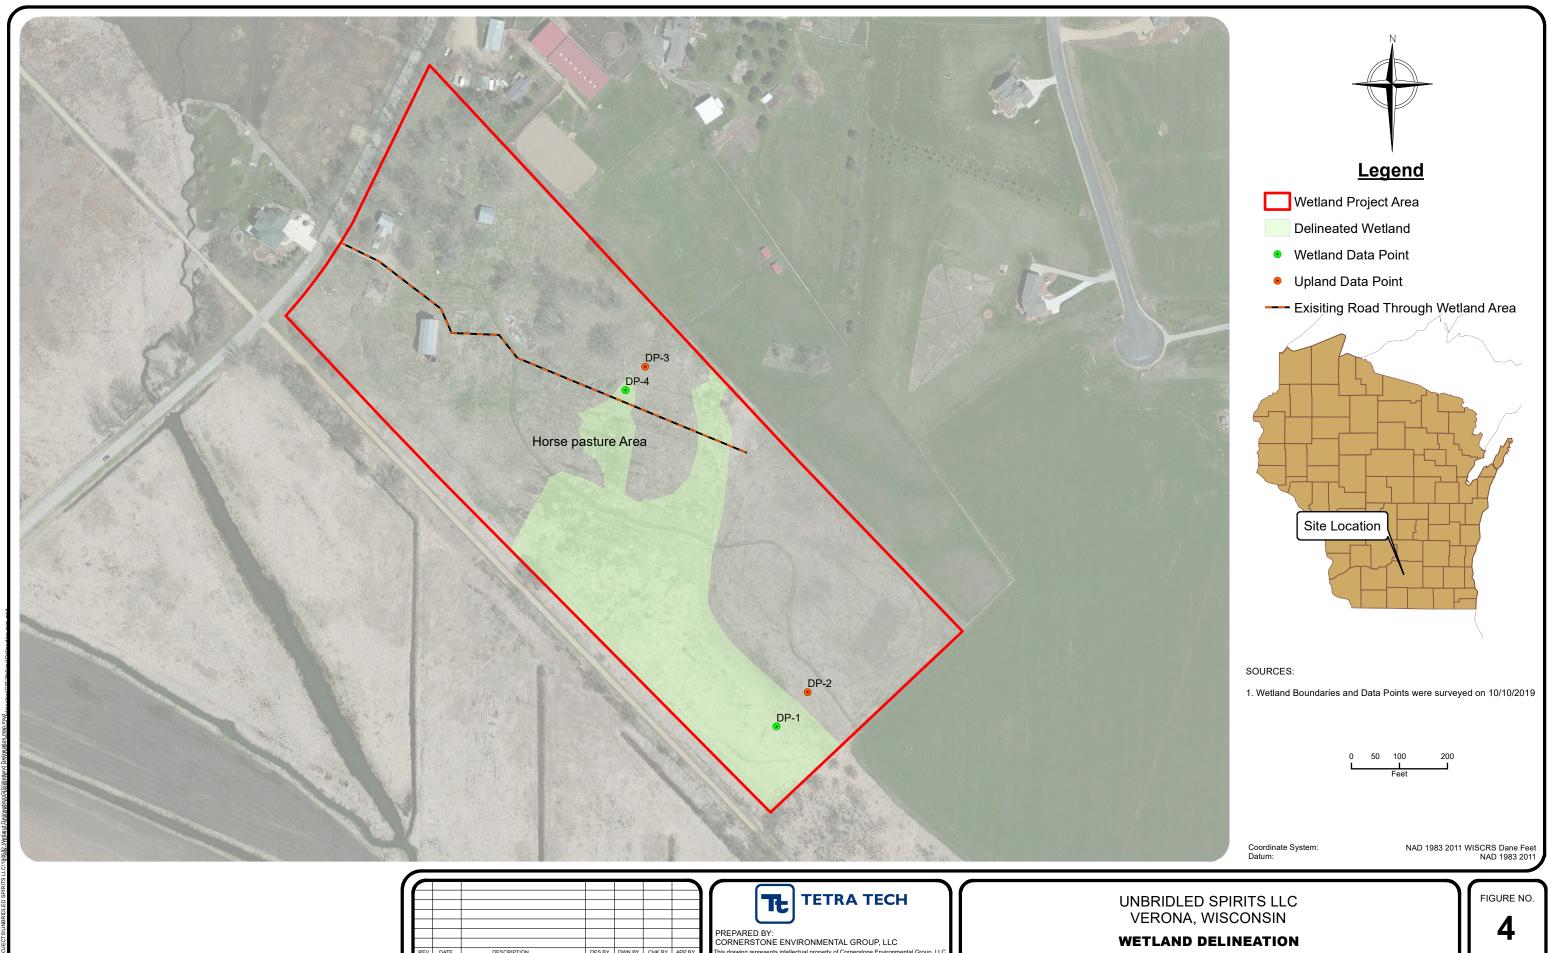

 DESIGNED BY
 LS
 CHECKED BY
 MT

 DRAWN BY
 LS
 APPROVED BY
 MT

DATE OF ISSUE

PROJECT NO. 190682

Wetland Delineation Map